

Approved Not Approved _____
Inspected by William M. King, R.S. Date 1/3/86
Sanitation or Health Officer

Date \$5.00 fee pd.
Permit No. 169

Carbon COUNTY HEALTH DEPARTMENT

INDIVIDUAL SEWAGE DISPOSAL INSTALLATION PERMIT APPLICATION

Owner San Campbell at Point of Rocks Subdivision
Lot Size 1/2 Acre Address Lot 12 Block 2 (COS 401 Abanda
Unit House Number of bedrooms 2
House, Trailer, Etc.


Maximum ground water depth during high water is over 6 from surface. Depth to Bedrock over 6
Foot

Water percolation rate is Established by Sanitary Protection Record
Minutes Per Inch

DISPOSAL SYSTEM:

Septic tank 1000 Gal. Length drainfield 250 sq ft. Pit NA
All disposal to septic tank Bypass _____ Garbage Disp. _____ Dishwasher _____
Distance from septic tank to: Foundation 10', Well 20', Nearest property line 10'
canal, stream, lake, etc. 50'
Distance from drainfield to: Foundation 15', well 100', Nearest property line 10'
canal, stream, lake, etc. 100'

SKETCH PROPOSED DISPOSAL SYSTEM (Include unit, well, stream, lake, etc. - neighbors well disposal system if in close proximity)

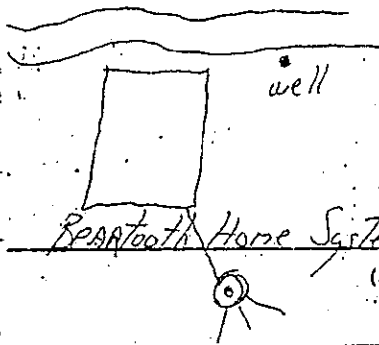

APPLICANT San Campbell
Signature

INSTALLATION DATE _____

Contractor Peartooth Horse Sutters Address 2526 Grand Ave Rte 17
(See Reverse for Comments)